

MASTER DEED

185 OLD COLONY AVENUE
CONDOMINIUM

UNIT A	185
UNIT B	186
UNIT C	187
UNIT D	188
UNIT E	189
UNIT F	190
UNIT G	191


EVERY UNIT IS TO REMAIN SEPARATELY OWNED, AND THE RULES AND REGULATIONS OF THE SOCIETY OF 1855.

PROJECT CODE: 185

HERBERT EBBERT HAS BEEN FULLY AND LEGALLY CERTIFIED AS TO THE LOCATION OF THE BUILDING AND DIMENSIONS OF THE UNITS HEREIN. HE HAS NO KNOWLEDGE OF ANY OTHER UNITS OR UNITS LOCATED AT 185 OLD COLONY AVENUE, BOSTON, MASSACHUSETTS, WHICH WOULD BE SUBJECT TO THIS MASTER DEED.


APPROVED: DATE


185 OLD COLONY AVENUE
CONDOMINIUM
BOSTON, MA
MASTER DEED

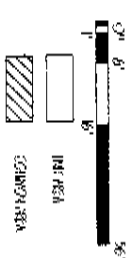

PER 77039

185 OLD COLONY AVENUE
CONDOMINIUM
BOSTON, MA 02116
185 OLD COLONY AVENUE
BOSTON, MA 02116

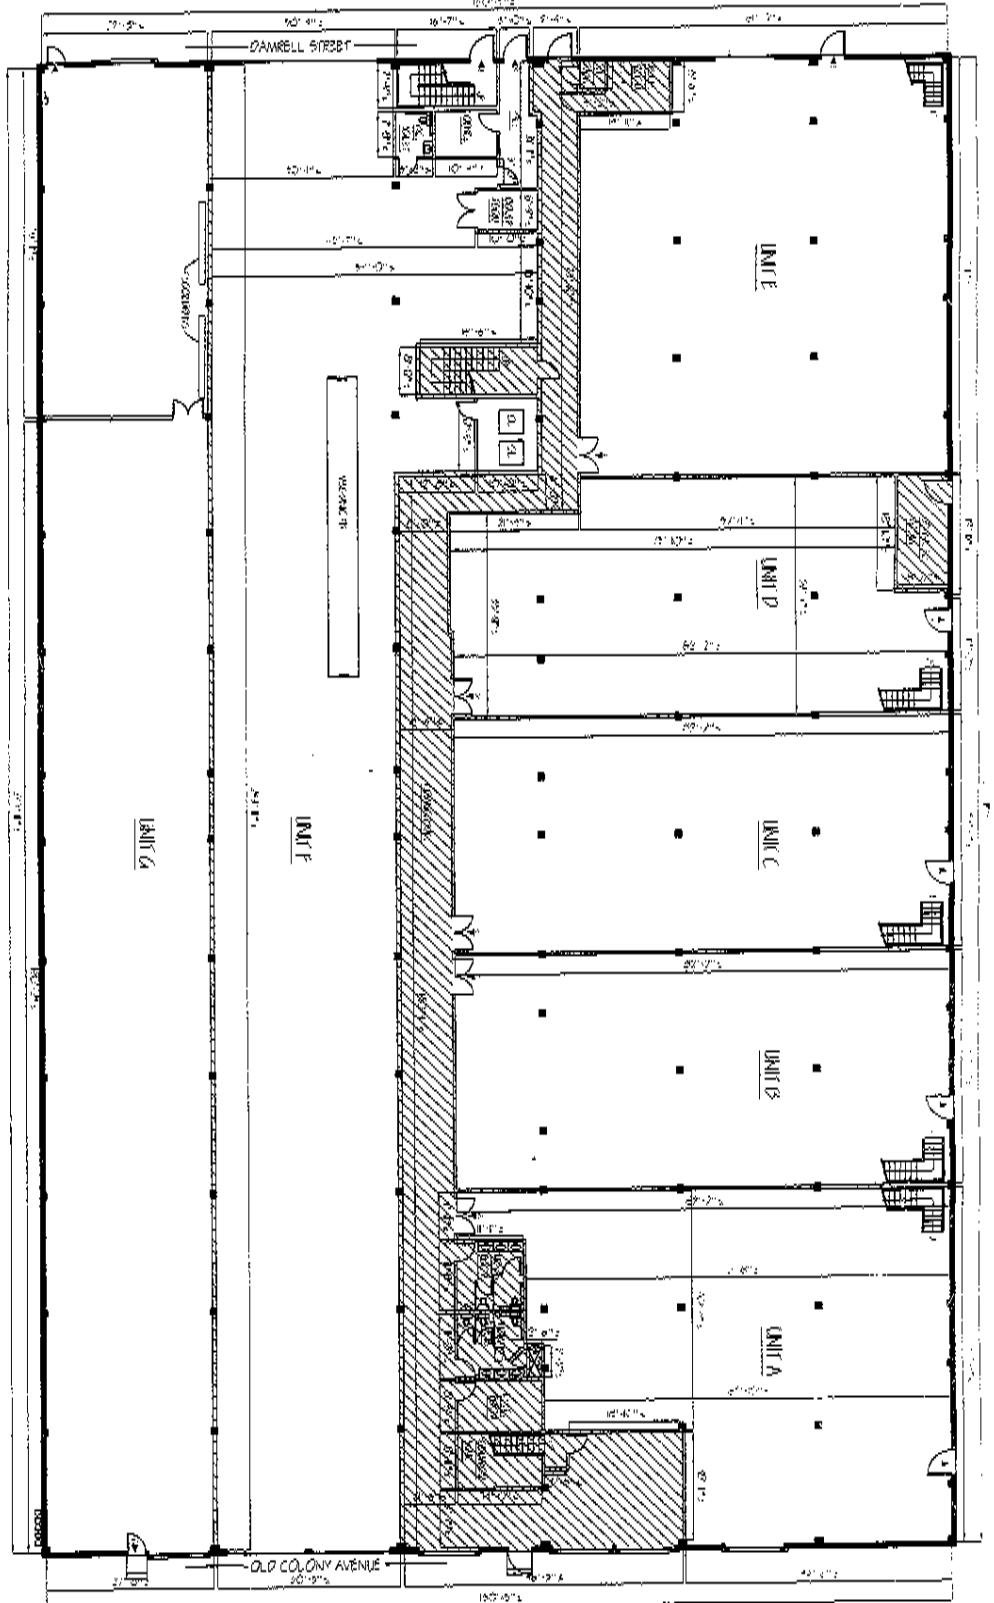

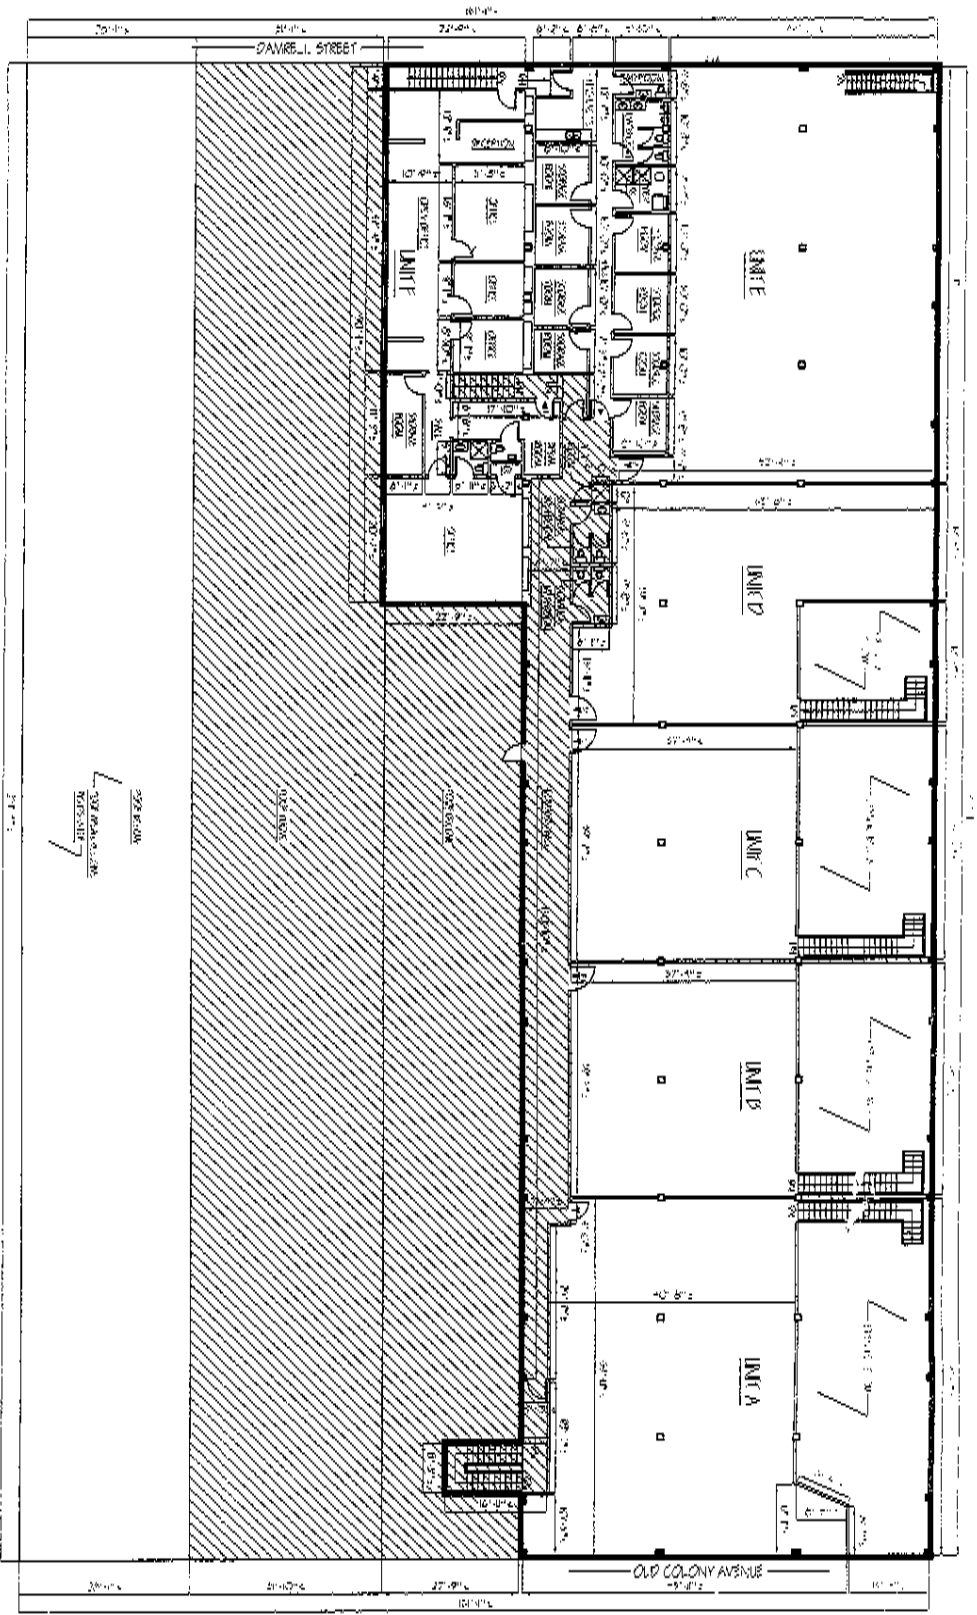

1
ECONOMIST

MASTER DEED

185 OLD COLONY AVENUE
CONDOMINIUM


UNIT A
UNIT B
UNIT C
UNIT D
UNIT E

RECEIVED
DATE

HEREBY CERTIFY THAT THE PLAN, MAP, AND RECORD DRAWINGS ARE THE LEGAL AND ACCURATE REPRESENTATION OF THE UNIT LITHEATED A RECORDING AND WAREHOUSE IN THE CITY OF BOSTON, MASSACHUSETTS AND HAVE BEEN LOCATED AT 185 OLD COLONY AVENUE, BOSTON, MASSACHUSETTS, 02116.

RECORDED
DATE

185 OLD COLONY AVENUE
CONDOMINIUM
BOSTON, MA
MASTER DEED

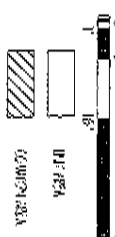

211 JERVIS ST.
BOSTON, MA 02116
185 Old Colony Avenue, Boston, MA 02116
CONDOMINIUM