


97 WOOD STREET, MIDDLEBOROUGH, MA

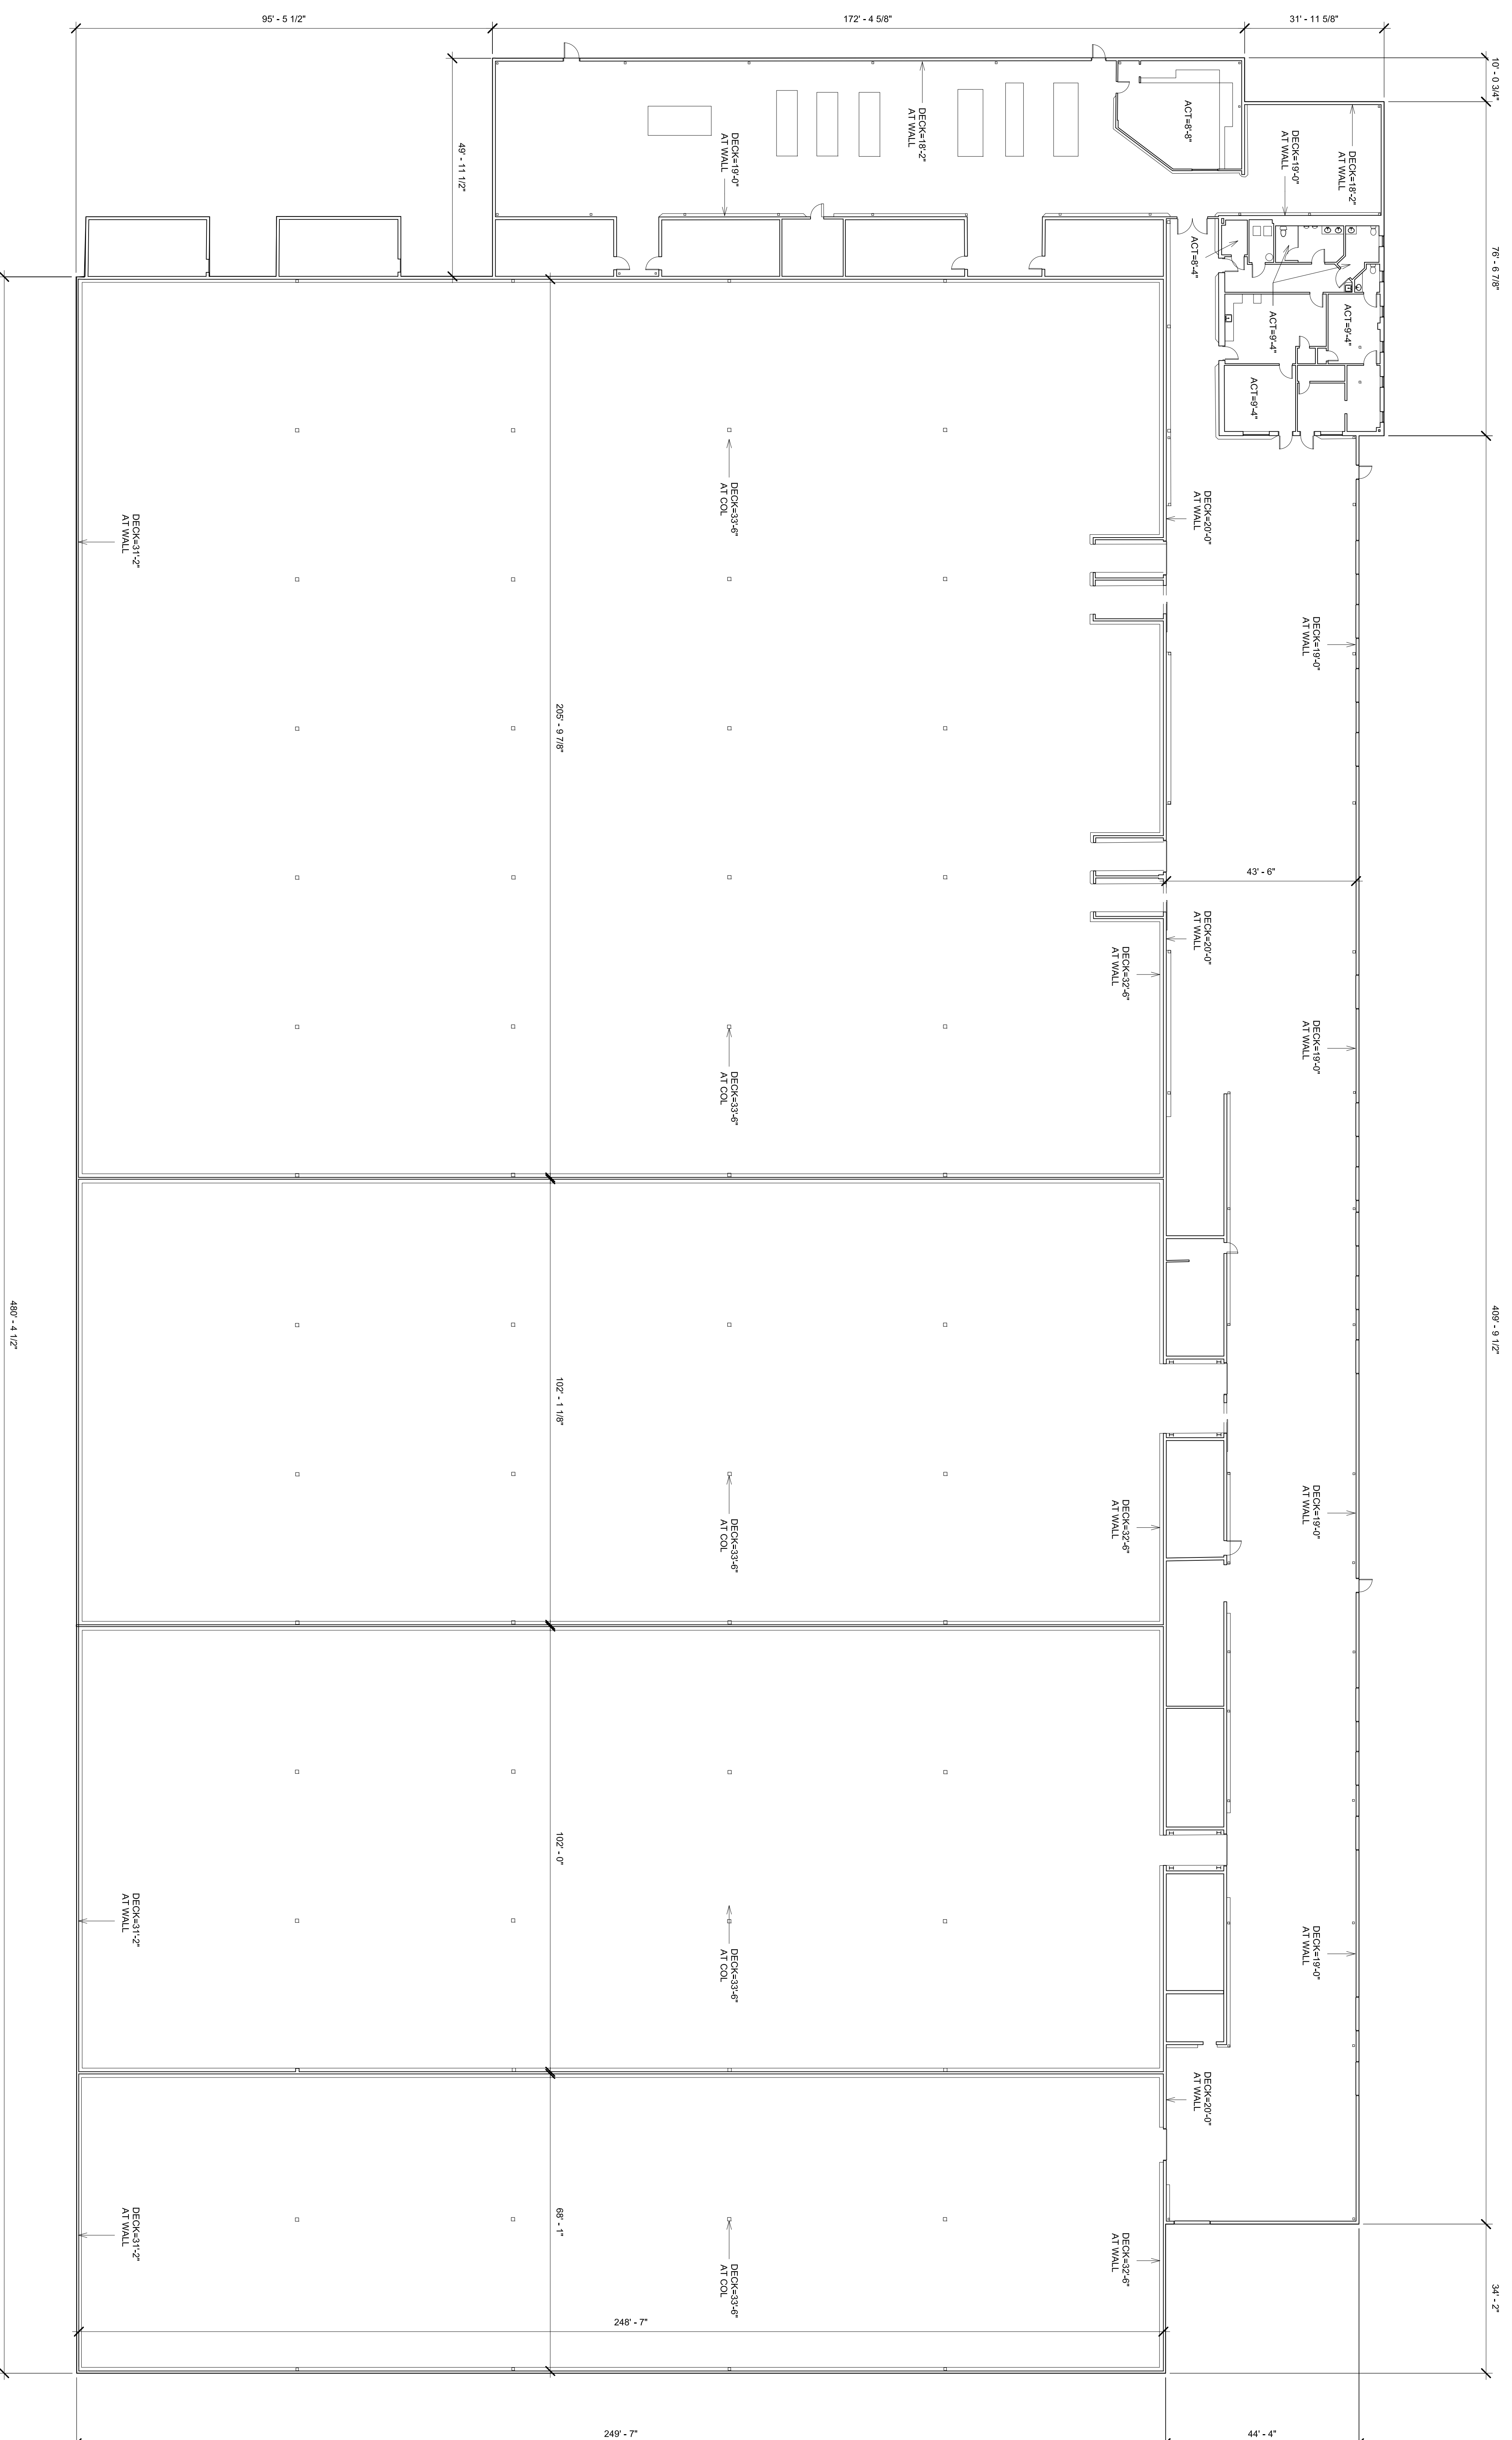

GROSS SQFT = 150,608
 NOTE: GROSS SQFT TAKEN AT EXTERIOR FACE OF EXTERIOR WALL

97 Wood Street

Middleborough, MA

**EXISTING
CONDITIONS**

Call us at (617) 247-9114
 info@existingconditions.com
 www.existingconditions.com

**The Most Accurate
Existing Conditions Surveys and
As-Built Surveys**

Existing Conditions Surveys and As-Built Surveys are the most accurate way to document the existing conditions of a building. They provide a detailed record of the building's structure, systems, and finishes, which is essential for renovation, restoration, and preservation projects.

1. We provide a comprehensive survey of the building's structure, systems, and finishes.
2. We provide a detailed record of the building's existing conditions, including the location and condition of all structural elements, systems, and finishes.
3. We provide a detailed record of the building's existing conditions, including the location and condition of all structural elements, systems, and finishes.
4. We provide a detailed record of the building's existing conditions, including the location and condition of all structural elements, systems, and finishes.
5. We provide a detailed record of the building's existing conditions, including the location and condition of all structural elements, systems, and finishes.

Revision Number	Revision Description	Revision Date
1	Revision 1	Date 1

Existing First Floor Plan

Owner: JES
 Date: 5/28/20
 Scale: 1/16" = 1'-0"
EX01