


ROSE STREET

WASHINGTON STREET

PARKDALE STREET

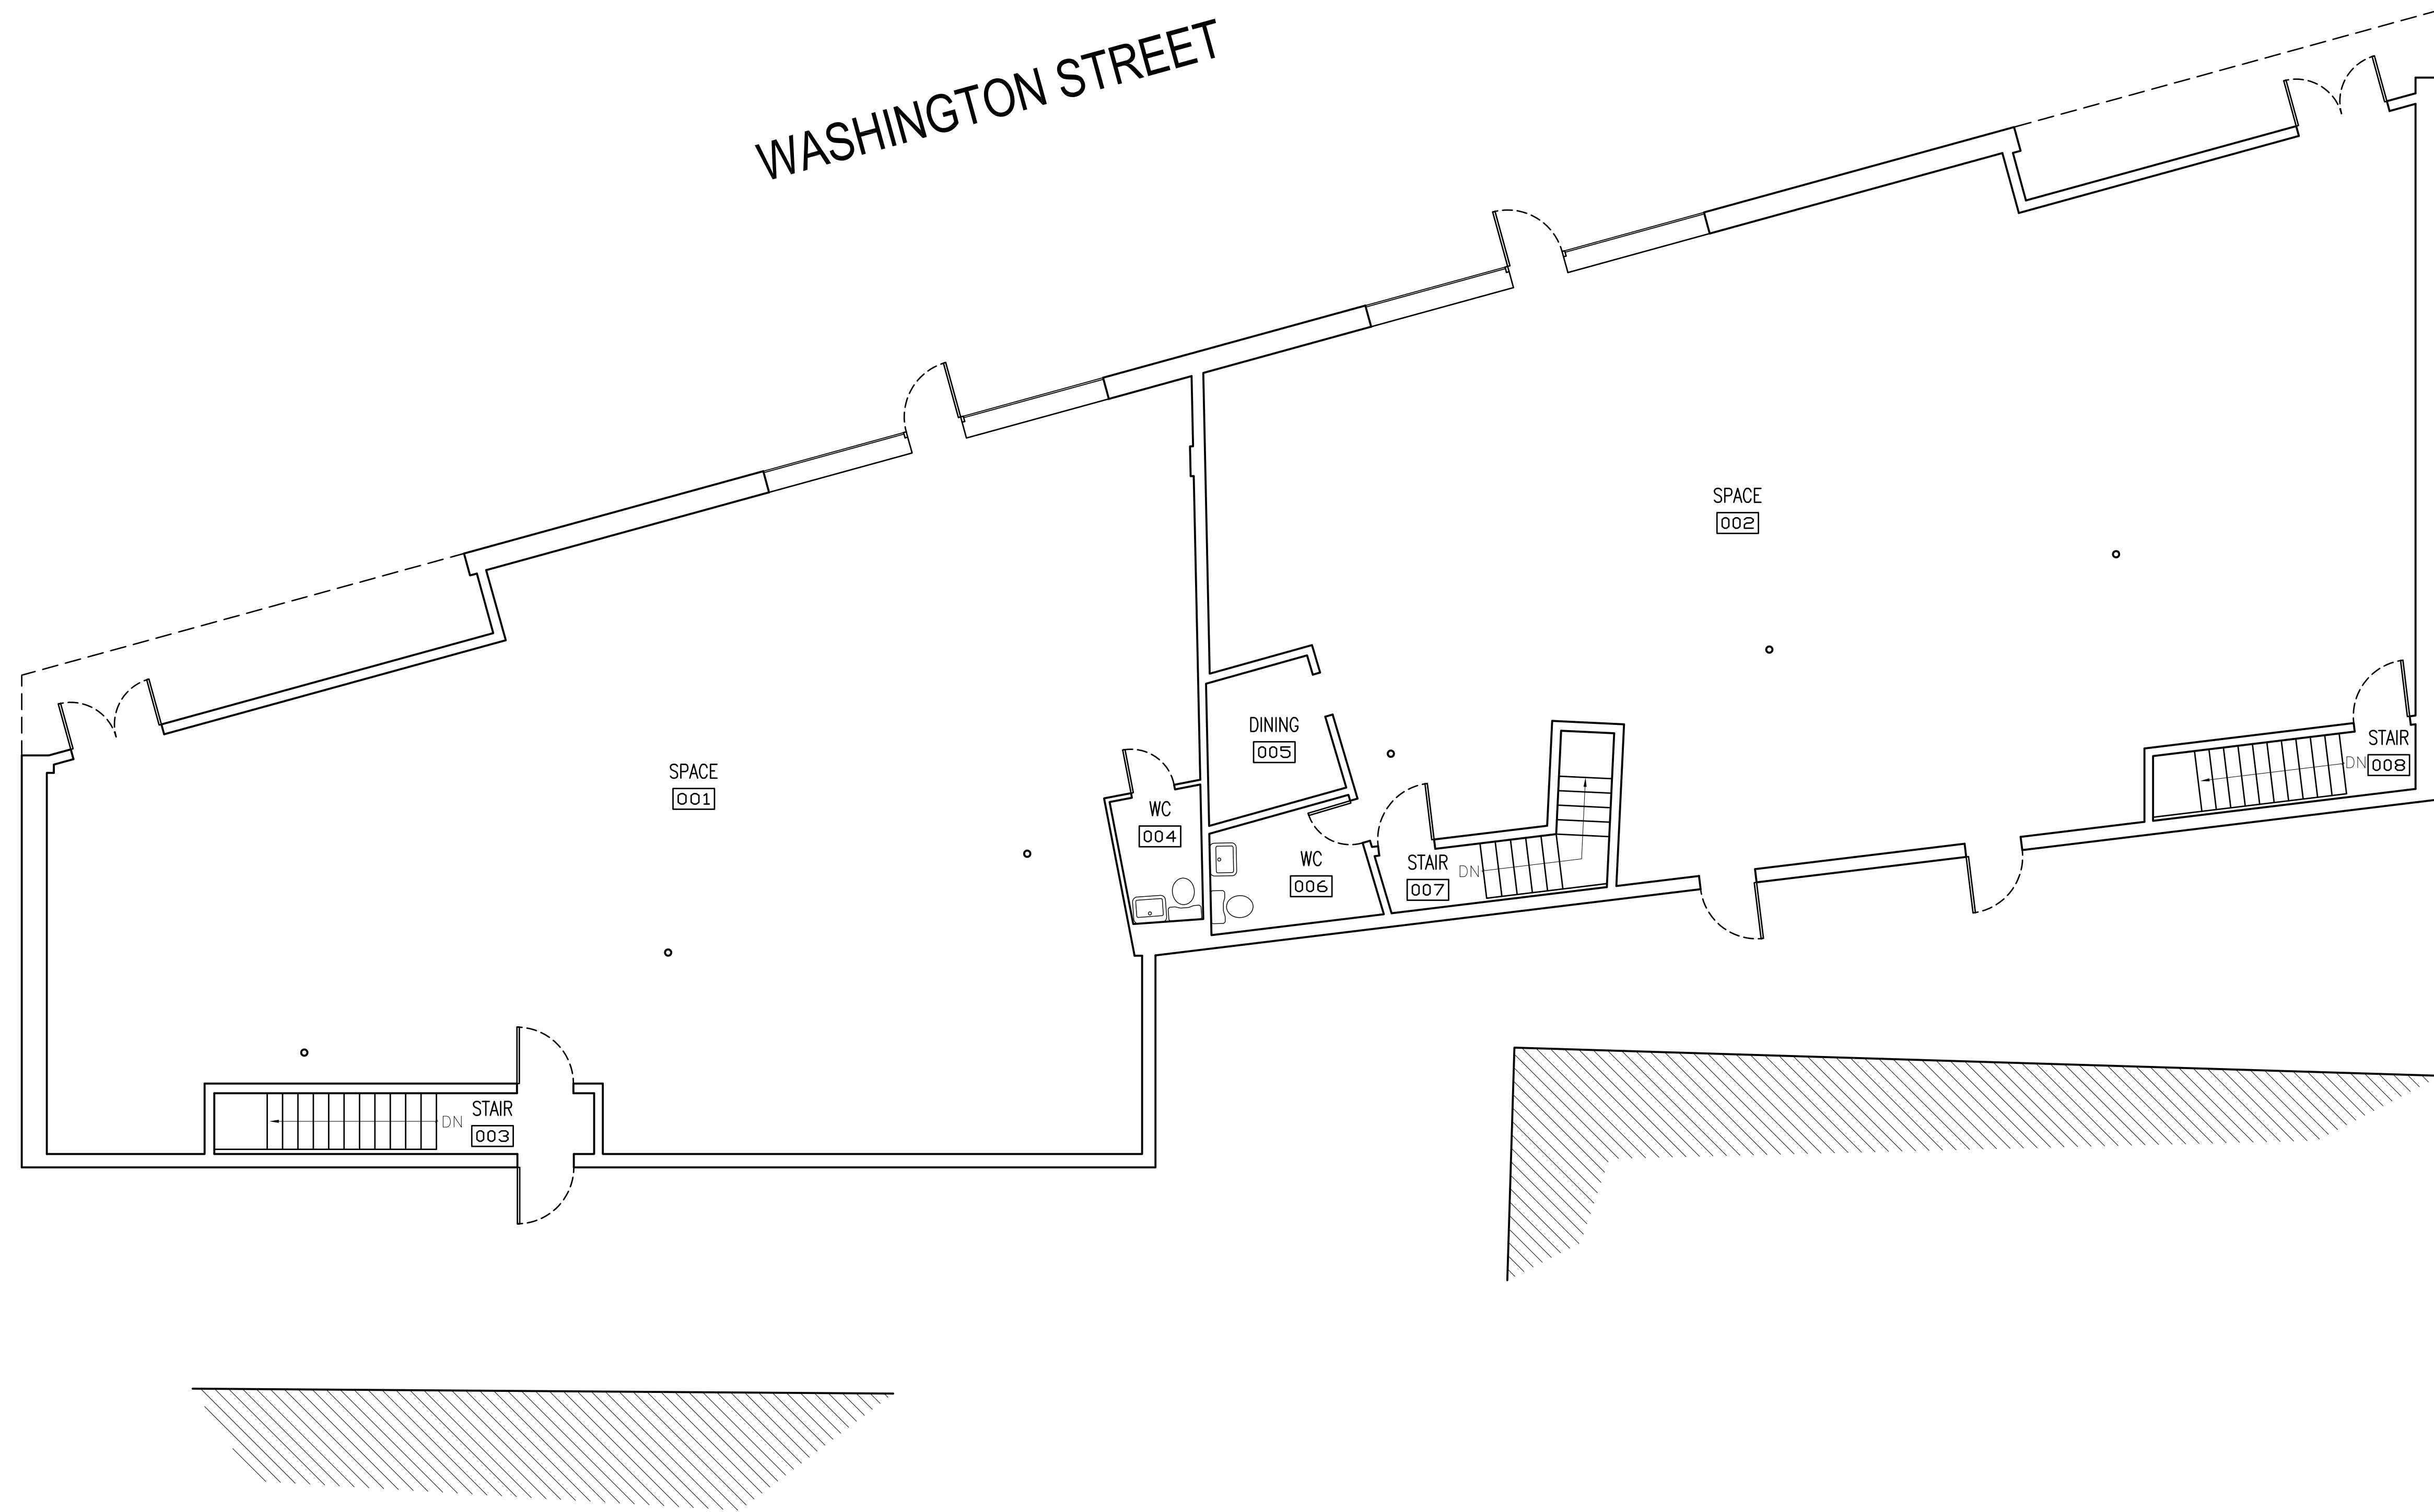

GROUND FLOOR PLAN

AS BUILT AT  
352 WASHINGTON STREET  
SOMERVILLE, MA 02143

